

SURVEY SKETCH OF ASBUILT SURVEY  
FINAL ON DECK, SCREENED ENCLOSURE AND POOL

BOUNDARY INFORMATION AND OTHER IMPROVEMENTS SHOWN HEREON WERE TAKEN FROM AN ASBUILT PURPOSE SURVEY BY THIS FIRM DATED 08/14/2018  
ELEVATIONS SHOWN ARE IN NAVD DATUM, WERE ACQUIRED USING GPS TECHNOLOGY AND HAVE A TOLERANCE OF +/- 0.2'

NOT FOR FENCE CONSTRUCTION

NOT FOR CONSTRUCTION

NOT FOR DESIGN

IMPROVEMENTS OTHER THAN THOSE SHOWN, IF ANY, WERE NOT LOCATED

STREET ADDRESS :

2415 PARSON ST  
NAPLES, FLORIDA

LINE TABLE

Line	Bearing	Distance
L1	N.54°22'32"E.	34.71' (P)
	N.54°26'23"E.	34.72' (M)
L2	S.54°22'32"W.	34.72' (P)
	S.54°06'19"W.	34.77' (C)
L3	S.54°22'32"W.	34.71' (P)
	S.54°07'59"W.	34.56' (M)

Curve number 1	Curve number 2
Radius= 665.00	Radius= 522.50
Delta= 02°11'13"	Delta= 02°11'13"
Arc= 25.38	Arc= 19.94
Tangent= 12.69	Tangent= 9.97
Chord= 25.38	Chord= 19.94
Chord Brg. N.55°28'08"E. (P)	Chord Brg. N.55°28'08"E. (P)
N.55°38'58"E. 25.36' (M)	N.55°52'09"E. 19.93' (C)
Curve number 3	Curve number 4
Radius= 500.00	Radius= 500.00
Delta= 28°06'46"	Delta= 02°11'13"
Arc= 245.33	Arc= 19.08
Tangent= 125.19	Tangent= 9.54
Chord= 242.88	Chord= 19.08
Chord Brg. S.68°25'55"W. (P)	Chord Brg. S.55°28'08"W. (P)
S.70°41'06"W. 243.76' (M)	S.55°19'23"W. 19.07' (M)

CERTIFICATION :

I CERTIFY THAT THIS SURVEY WAS MADE UNDER MY RESPONSIBLE CHARGE.

BY : *Leland F. Dysard* SURVEY DATE : 10/05/2018

CLINTON W. FINSTAD, PE, CFM, PLS #2453 LELAND F. DYSARD, PLS #3859  
MARY E. FINSTAD, CFM, PSM #5901

NOT VALID WITHOUT SURVEYOR'S SIGNATURE AND EMBOSSED SEAL  
NOT A CERTIFICATION OF TITLE, ZONING, EASEMENTS OR FREEDOM OF ENCUMBRANCES.  
FLORIDA STATUTE 5J-17.05 (3) (c): TWO SITE BENCHMARKS REQUIRED FOR CONSTRUCTION  
NOTE: PROPERTY OWNER SHOULD OBTAIN WRITTEN FLOOD ZONE DETERMINATION FROM LOCAL PERMITTING,  
PLANNING AND BUILDING DEPARTMENT PRIOR TO ANY CONSTRUCTION PLANNING AND/OR CONSTRUCTION.

F.L.A. SURVEYS CORP.  
PROFESSIONAL LAND SURVEYORS & MAPPERS-LB 6569

DRAWN BY: SVU PARTY CHIEF: VL

3884 PROGRESS AVE., SUITE 104  
NAPLES, FL 34104  
239-403-1600 FAX 403-8600  
239-404-7129 239-580-2795  
239-250-2792 239-825-8504  
9220 BONITA BEACH ROAD, STE 200  
BONITA SPRINGS, FL 34135

NOTE:  
IN COMPLIANCE WITH F.A.C.  
5J-17.052 (2) (d) (4) (IF LOCATION OF  
EASEMENTS OR RIGHT-OF-WAY OF RECORD,  
OTHER THAN THOSE ON RECORD PLAT, IS  
REQUIRED, THIS INFORMATION MUST BE  
FURNISHED TO THE SURVEYOR AND MAPPER.

NOTE: IF APPLICABLE, FENCES SHOWN MEASUREMENT  
ON OR OFF LINES. (APPROX. LOCATION ONLY)

QUALITY CONTROL


BY : MEF DATE : 10/09/2018  
I CERTIFY THAT THIS SURVEY MEETS THE STANDARDS OF PRACTICE SET  
FORTH BY THE BOARD OF PROFESSIONAL SURVEYORS AND MAPPERS IN  
CHAPTER 5J-17.053, FLORIDA ADMINISTRATIVE CODE, PURSUANT TO  
SECTION 472.027, FLORIDA STATUTES.

REVISIONS

PROJECT NO:  
18-88160-SPC

SET BACKS-OK  
INITIALS  
OCT 11, 2018

Collier County Bldg  
Review + Permitting

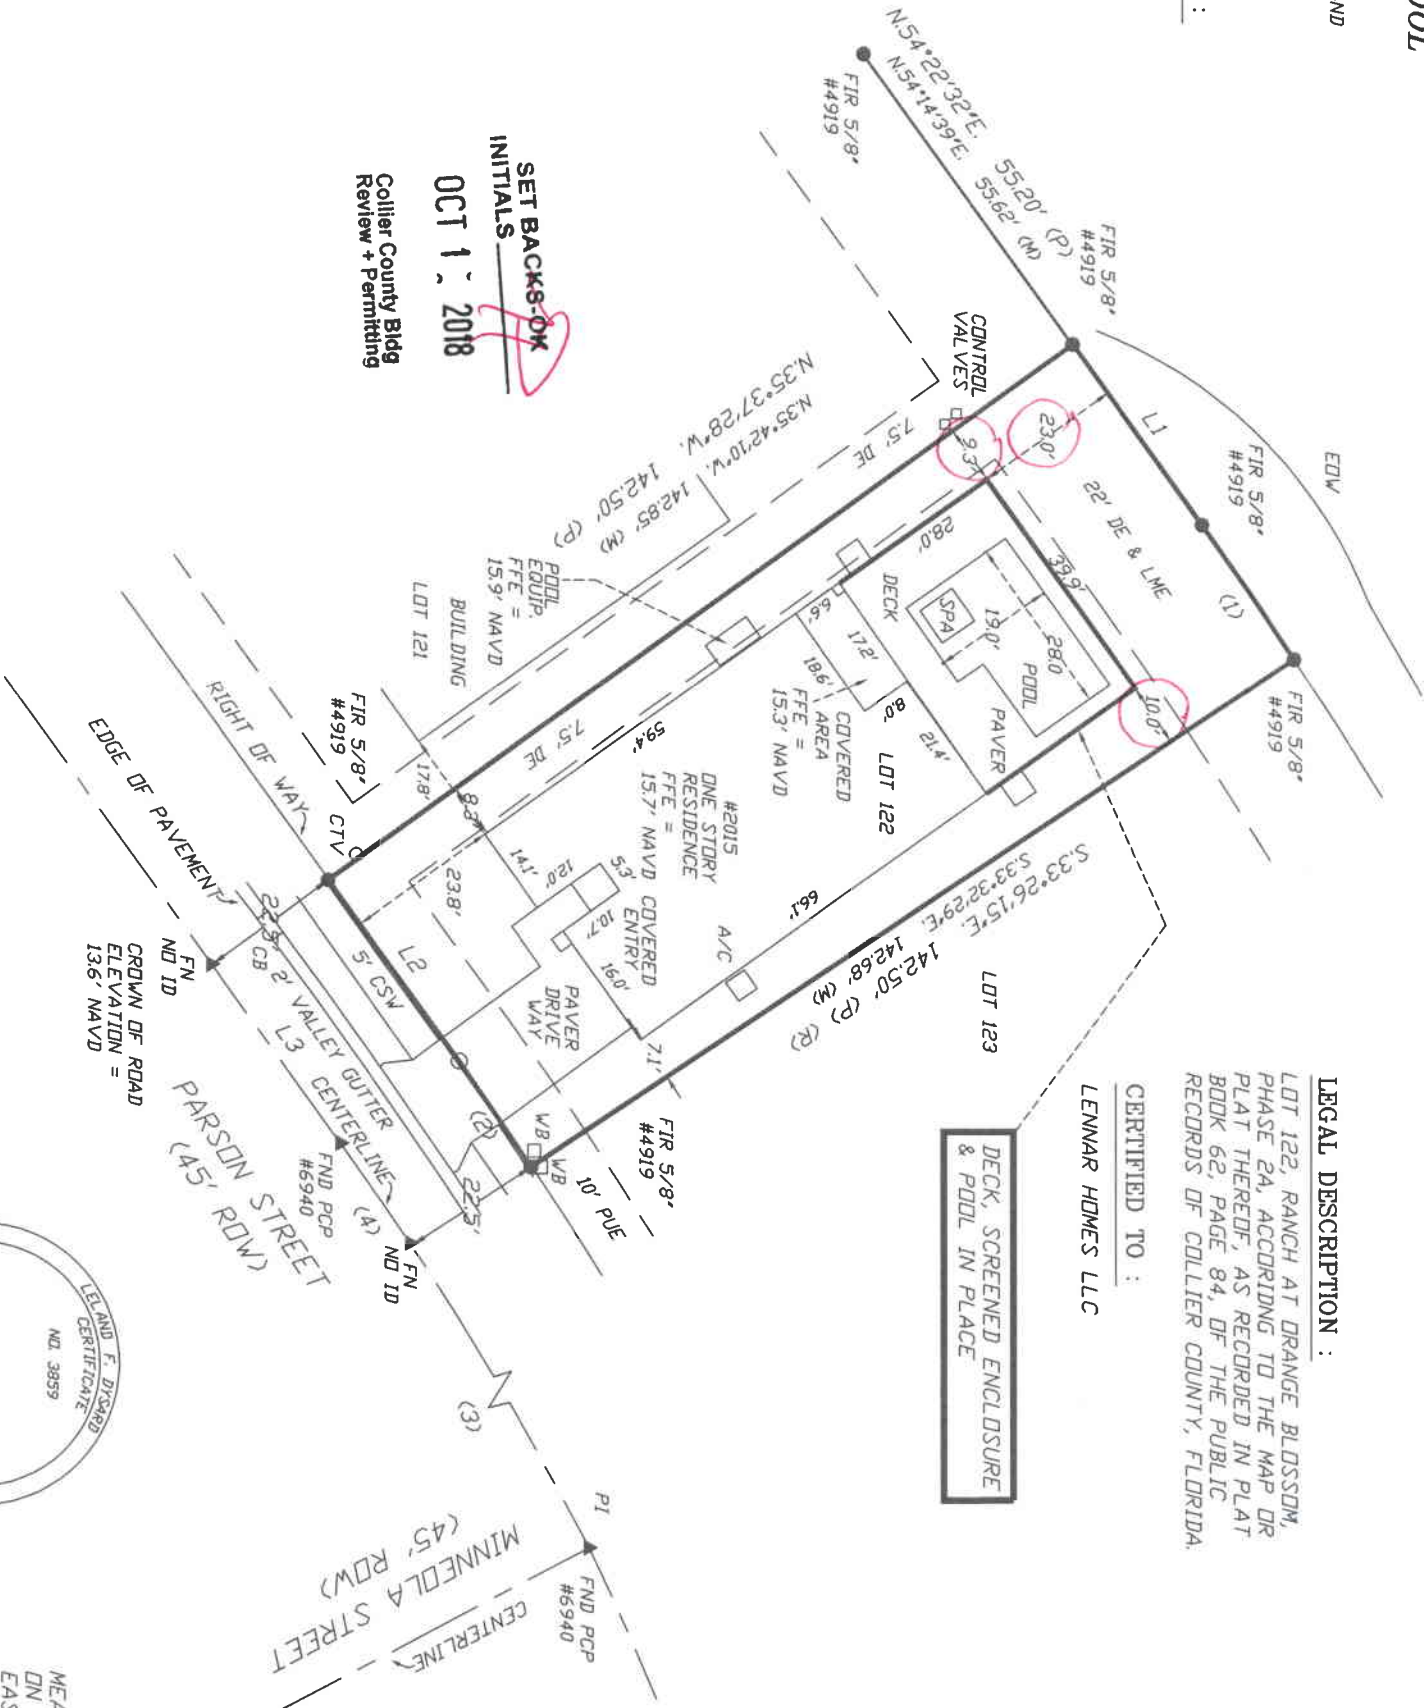

LEGAL DESCRIPTION :


LOT 122, RANCH AT ORANGE BLOSSOM,  
PHASE 2A, ACCORDING TO THE MAP OR  
PLAT THEREOF, AS RECORDED IN PLAT  
BOOK 62, PAGE 84, OF THE PUBLIC  
RECORDS OF COLLIER COUNTY, FLORIDA.

CERTIFIED TO :

LENNAR HOMES LLC



SCALE: 1" = 30'

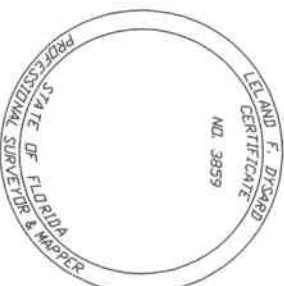

SCREEN 20180848408



**PAGE 3 OF 3**  
**NOT VALID WITHOUT**  
**PAGES 1 AND 2 OF 3**

**GENERAL NOTES**  
**ABSTRACT NOT REVIEWED**

**N = NORTH**

**S = SOUTH**

**E = EAST**

**W = WEST, OR ANY COMBINATION THEREOF**

1. ° = DEGREES
2. ' = MINUTES WHEN USED IN A BEARING
3. " = SECONDS WHEN USED IN A BEARING
4. ' = FEET WHEN USED IN A DISTANCE
5. " = INCHES WHEN USED IN A DISTANCE
6. ± = "MORE OR LESS" OR "PLUS OR MINUS"
7. A = ARC DISTANCE
8. AC = ACRES
9. A/C = AIR CONDITIONING PAD
10. AE = ACCESS EASEMENT
11. B.E. = BUFFER EASEMENT
12. BM = BENCHMARK
13. BOB = BASIS OF BEARING
14. BRG = BEARING
15. C# = CURVE NUMBER
16. C = CALCULATED
17. CB = CATCH BASIN
18. CHB = CHORD BEARING
19. CHD = CHORD
20. CLF = CHAINLINK FENCE
21. CM = CONCRETE MONUMENT
22. CO = CLEAN OUT
23. CONC = CONCRETE
24. CP = CONCRETE PAD
25. CSW = CONCRETE SIDEWALK
26. CTV = CABLE TV RISER
27. CUE = COLLIER COUNTY UTILITY EASEMENT
28. D = DEED
29. DE = DRAINAGE EASEMENT
30. DH = DRILL HOLE
31. DI = DROP INLET
32. ELEC = ELECTRIC
33. EOP = EDGE OF PAVEMENT
34. EOR = EDGE OF ROAD
35. EOW = EDGE OF WATER
36. F = AS LABELED OR FOUND IN THE FIELD
37. F.A.C. = FLORIDA ADMINISTRATIVE CODE
38. FCC = FOUND CROSS CUT
39. FCM = FOUND CONCRETE MONUMENT
40. FEMA = FEDERAL EMERGENCY MANAGEMENT AGENCY
41. FDH = FOUND DRILL HOLE
42. FFE = FINISH FLOOR ELEVATION
43. FH = FIRE HYDRANT
44. FIP = FOUND IRON PIPE
45. FIR = FOUND IRON ROD
46. FN = FOUND NAIL
47. FND = FOUND
48. FPK = FOUND PK NAIL
49. FPK&D = FOUND PK NAIL AND DISC
50. GTE = TELEPHONE RISER
51. ILLEG. = ILLEGIBLE LB OR PSM NUMBER
52. LB = LICENSED BUSINESS
53. LBE = LANDSCAPE BUFFER EASEMENT
54. LME = LAKE MAINTENANCE EASEMENT
55. LP = LIGHT POLE
56. M = MEASURED
57. ME = MAINTENANCE EASEMENT
58. MH = MANHOLE
59. NAVD 1988 = NORTH AMERICAN VERTICAL DATUM OF 1988
60. NGVD 1929 = NATIONAL GEODETIC VERTICAL DATUM OF 1929
61. NO ID = NO IDENTIFYING MARKINGS
62. (NR) = NON-RADIAL
63. NTS = NOT TO SCALE
64. OHP = OVERHEAD POWER
65. OHU = OVERHEAD UTILITY LINE
66. O.R. = OFFICIAL RECORD BOOK
67. P = PLAT
68. PC = POINT OF CURVATURE
69. PCC = POINT OF COMPOUND CURVATURE
70. PCP = PERMANENT CONTROL POINT
71. PG = PAGE
72. PI = POINT OF INTERSECTION
73. PK&D = PARKER KALON NAIL AND DISC
74. PLS = PROFESSIONAL LAND SURVEYOR
75. POB = POINT OF BEGINNING
76. POC = POINT OF COMMENCEMENT
77. PP = POWER POLE
78. PRC = POINT OF REVERSE CURVE
79. PRM = PERMANENT REFERENCE MONUMENT
80. PSM = PROFESSIONAL SURVEYOR AND MAPPER
81. PU & DE = PUBLIC UTILITY & DRAINAGE EASEMENT
82. PUE = PUBLIC UTILITY EASEMENT

83. (R) = RADIAL
84. R = RADIUS
85. RING = ITEM DETECTED BY METAL DETECTOR BUT NOT RECOVERED
86. RNG = RANGE
87. ROW = RIGHT-OF-WAY
88. RR SPK = RAILROAD SPIKE
89. SAT = SATELLITE DISH
90. SEC = SECTION
91. SPK&D = SET PK WITH DISC WITH LB NUMBER
92. SIR = SET 5/8" IRON ROD WITH LB NUMBER
93. TBM = TEMPORARY BENCH MARK
94. TECO = TAMPA ELECTRIC COMPANY
95. TEL = TELEPHONE FACILITIES
96. TOB = TOP OF BANK
97. TP = TRANSMITTER PAD
98. TUE = TECHNOLOGY UTILITY EASEMENT
99. TVR = TELEVISION RISER
100. TWP = TOWNSHIP
101. UE = UTILITY EASEMENT
102. VF = VINYL FENCE
103. W = WATER SERVICE
104. WB = WATER BOX
105. WF = WOOD FENCE
106. WPP = WOOD POWER POLE
107. WREC = WITHLACOOCHIE RIVER ELECTRIC COMPANY
108. Δ = DELTA OR CENTRAL ANGLE OF CURVE
109. DIMENSIONS ARE IN FEET AND IN DECIMALS THEREOF
110. ELEVATIONS SHOWN HEREON ARE NAVD 1988 UNLESS OTHERWISE STATED
111. ALL PHYSICAL IMPROVEMENTS SHOWN WITHOUT DIMENSIONS ARE FOR INFORMATIONAL PURPOSES ONLY. THAT THEY DO EXIST, BUT WERE NOT NECESSARILY MEASURED IN THE FIELD.
112. NOTE: LEGAL DESCRIPTION PROVIDED BY CLIENT UNLESS OTHERWISE NOTED.
113. EASEMENTS AND RIGHT OF WAYS SHOWN ARE PER RECORDED PLAT OR AS FURNISHED BY THE CLIENT
114. FOUNDATION LINE BELOW THE SURFACE OF THE GROUND IS NOT REFLECTED
115. THIS SURVEY IS NOT TO BE USED FOR CONSTRUCTION PURPOSES UNDER ANY CONDITION UNLESS OTHERWISE STATED
116. NO UNDERGROUND INSTALLATIONS OR IMPROVEMENTS HAVE BEEN LOCATED EXCEPT AS NOTED
117. NO INSTRUMENTS OF RECORD REFLECTING EASEMENTS, RIGHT OF WAYS, AND/OR OWNERSHIP WERE FURNISHED THIS SURVEYOR EXCEPT AS SHOWN
118. THERE ARE NO VISIBLE ENCROACHMENTS EXCEPT THOSE AS DELINEATED ON THIS PLAT OF SURVEY
119. TIES ARE TO FIELD LINES UNLESS OTHERWISE NOTED
120. THERE MAY BE ADDITIONAL RESTRICTIONS AND/OR EASEMENTS THAT ARE NOT RECORDED ON SAID PLAT THAT MAY BE FOUND IN THE PUBLIC RECORDS OF THIS COUNTY
121. FENCES MEANDER ON AND OFF LINE, APPROXIMATE LOCATION ONLY UNLESS STATED OTHERWISE.
122. THE LINES ON THIS SKETCH DO NOT CONSTITUTE OWNERSHIP
123. THE INTENT OF THIS SURVEY IS FOR TITLE TRANSFER ONLY UNLESS STATED OTHERWISE.
124. FLORIDA STATUTE : TWO SITE BENCHMARKS ARE REQUIRED FOR CONSTRUCTION.
125. THIS SURVEY DOES NOT REFLECT OR DETERMINE OWNERSHIP.
126. 121. F.E.M.A. FLOOD HAZARD MAPPING: THIS DATE PRODUCT WAS NOT DESIGNED TO MAKE PRECISE IN/OUT FLOOD RISK DETERMINATIONS. THIS PRODUCT IS NOT SUITABLE FOR ENGINEERING APPLICATIONS AND CANNOT BE USED TO DETERMINE ABSOLUTE DELINEATIONS OF FLOOD BOUNDARIES. CALL 1-877-FEMAMAP OR EMAIL A MAP SPECIALIST AT:  
[HTTP://WWW.FEMA.GOV/PLAN/PREVENT/FHM/TSD\\_EMAP.SHT](http://www.fema.gov/plan/prevent/fhm/tsd_emap.sht)  
PROPERTY OWNER SHOULD OBTAIN WRITTEN FLOOD ZONE DETERMINATION FROM LOCAL PERMITTING, PLANNING AND BUILDING DEPARTMENT PRIOR TO ANY CONSTRUCTION PLANNING AND/OR CONSTRUCTION
127. IN COMPLIANCE WITH F.A.C. 5J-17.052(2)(D)(4) - IF LOCATION OF EASEMENTS OR RIGHT-OF-WAY OF RECORD, OTHER THAN THOSE ON RECORD PLAT, IS REQUIRED, THIS INFORMATION MUST BE FURNISHED TO THE SURVEYOR AND MAPPER.
128. IF APPLICABLE, FENCES SHOWN MEANDER ON OR OFF LINES (APPROXIMATE LOCATION ONLY)
129. ARCHITECTURAL FEATURES, SUCH AS FURRING STRIPS, SIDING, CORNICES, STUCCO, ETC., OUTSIDE THE LINE OF THE STRUCTURE HAVE BEEN TAKEN INTO ACCOUNT WHEN GIVING TIES FROM THE STRUCTURE TO THE LOT LINES.
130. ATTENTION IS DIRECTED TO THE FACT THAT THIS SURVEY MAY HAVE BEEN REDUCED OR ENLARGED IN SIZE DUE TO REPRODUCTION. THIS SHOULD BE TAKEN INTO CONSIDERATION WHEN OBTAINING SCALED DATA.



NOT FOR FENCE CONSTRUCTION  
NOT FOR CONSTRUCTION  
NOT FOR DESIGN

**PHOTO PAGE**



<b>F.L.A. SURVEYS CORP.</b> PROFESSIONAL LAND SURVEYORS & MAPPERS - LB 6569			3884 PROGRESS AVE., SUITE 104 NAPLES, FLORIDA 34104 239-403-1600 FAX 403-8600	REVISIONS
			9220 BONITA BEACH ROAD, STE. 200 BONITA SPRINGS, FLORIDA 34135 239-403-1600 FAX 403-8600	PROJECT NO. 18-88160
DRAWN BY: LFD	PARTY CHIEF:	N/A		