

LEGEND:

PROPOSED PROJECT AREA


- NOTES:
1. COLLIER COUNTY PROPERTY APPRAISER, NAPLES FL 2013 AERIAL
 2. FLUCCS AREAS SHOWN PER CREEKSIDE EAST THREATENED AND ENDANGERED SPECIES SURVEY, BY TURRELL, HALL & ASSOCIATES, INC. DATED SEPTEMBER 2013.

PROJECT AREA FLUCCS LEGEND

CODE	DESCRIPTION	NATIVE VEGETATION ACREAGE	NON-NATIVE VEGETATION ACREAGE	TOTAL ACREAGE
411E1	PINE FLATWOODS (25%-50% EXOTICS)	3.45		3.45
422	BRAZILIAN PEPPER		0.57	0.57
7429	DISTURBED SWALE	-	-	0.17
814	ROADS AND HIGHWAYS	-	-	0.10
193	URBAN LAND IN TRANSITION	-	-	0.08
	TOTAL	3.45	0.57	4.36

SURROUNDING PROJECT AREA FLUCCS LEGEND

CODE	DESCRIPTION	AREA (AC.)
193	URBAN LAND IN TRANSITION	5.81
411	PINE FLATWOODS	1.63
411E1	PINE FLATWOODS (25%-50% EXOTICS)	7.41
414	OAK PINE COMMUNITY	1.14
422	BRAZILIAN PEPPER	2.86
510	STREAMS AND WATERWAYS	0.47
534	STORMWATER MANAGEMENT LAKE	1.82
630	WETLAND FORESTED MIXED	2.28
7429	DISTURBED SWALE	.14
743	SPOIL AREAS	0.25
814	ROADS AND HIGHWAYS	.73
	TOTAL	24.55

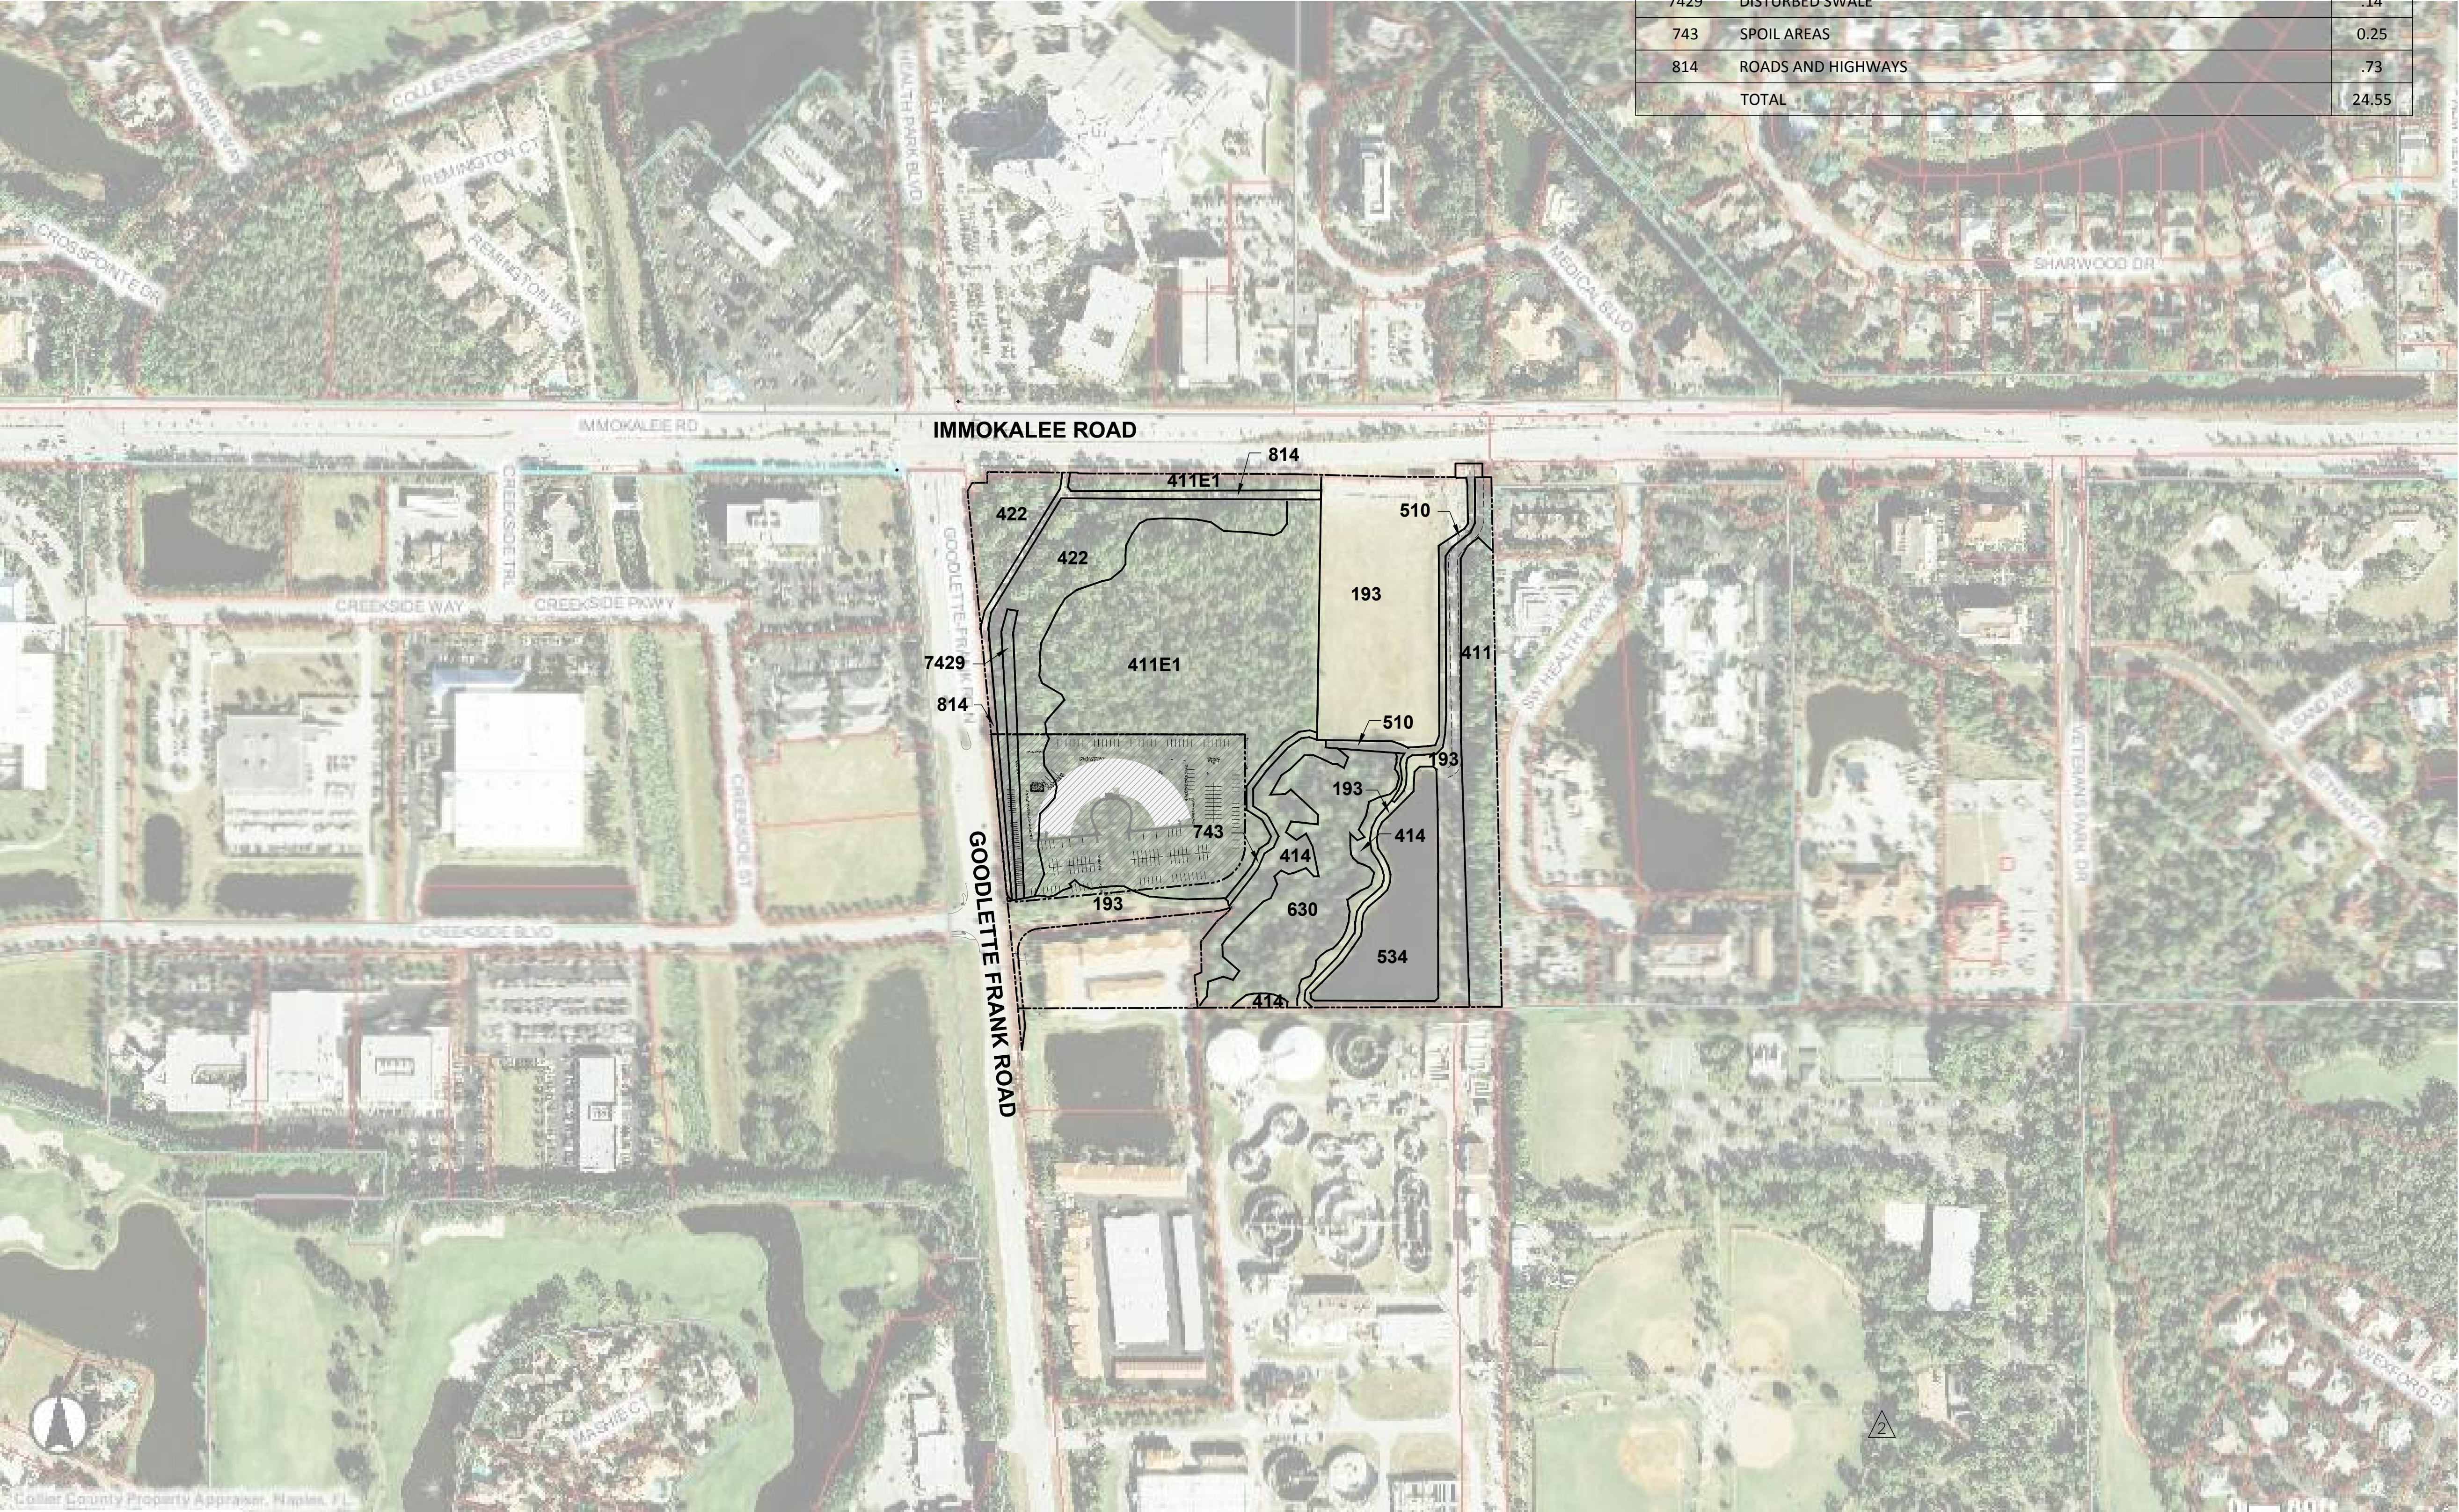

RECORD DRAWING

INFORMATION DEPICTED HEREON IS BASED ON THE AS-BUILT SURVEY PREPARED BY METRON SURVEYING & MAPPING, LLC, LAST REVISED 7-27-15. THIS INFORMATION HAS NOT BEEN FIELD VERIFIED BY OUR OFFICE.

385 DOUGLAS AVENUE, STE 2100
ALHAMBRA, CA 91801
TELEPHONE 407 478 8749
FACSIMILE 407 478 8749
www.klimaweeks.com

Klima
Weeks
CIVIL ENGINEERING

SEAL Selby G. Weeks, PE No. 56991

LANDMARK Long-Term
Acute Care
Hospital &
HOSPITALS Office Building

Hunton Brady
ARCHITECTS

DATE	SUBMISSION	NO.
12.10.13	CONSTRUCTION DOCUMENTS	
03.13.14	ADDENDUM No. 2	2

AERIAL VIEW AND
FLUCCS MAP

PROJ. NO. H-11145.00 SHEET
DRAWN EII/RVZ

C001