



Collier County
Public Utilities Department
Engineering & Project Management Division

April 23, 2019

VIA: E-MAIL

Kristina M. Johnson, P.E.
Director of Land Development
J.R. Evans Engineering, P.A.
9351 Corkscrew Road, Suite 102
Estero, Florida 33928

KJohnson@jreeng.com

Subject: Wastewater Service Availability
Project: Courthouse Shadows
Parcel #: 28750000523, 28750000769, 30480040100

Dear Kristina:

The subject project is within the Collier County Water-Sewer District's (CCWSD) wastewater service area and the City of Naples' water service area.

This property already receives wastewater service from the CCWSD. Adequate capacity for the proposed redevelopment project will be confirmed during the development review process and any system upgrades necessary to support the project will be the responsibility of the developer. Additional connections to the existing 8" gravity sewers along Collee Court and Peters Avenue may be allowed if adequate capacity is confirmed.

Connection to the CCWSD's wastewater collection system will be permitted only in the locations referenced herein, or in a superseding service availability letter, and only after the GMD Development Review Division's approval of hydraulic calculations prepared by the Developer's Engineer of Record in accordance with the Design Criteria found in Section 1 of the Collier County Water-Sewer District Utilities Standards Manual. Adequate capacity to this project is not guaranteed until the project receives a commitment for service.

A preliminary utility plan must be reviewed and discussed at a pre-submittal conference with representatives of the Public Utilities Department and the Growth Management Department, as required by Sec. 134-58, paragraph (b)(2) of the Code of Ordinances. This conference may be conducted by email at the discretion of the Public Utilities Department.

See the attached GIS screen shot and record drawings for approximate utility locations.



If you have any questions, you may contact me at (239) 252-1037 or Eric.Fey@colliercountyfl.gov.


Respectfully,

A handwritten signature in blue ink, appearing to read 'Eric Fey', with a stylized flourish at the end.

Eric Fey, P.E., Senior Project Manager

CC: Beth Johnssen, Division Director – Wastewater, PUD/WWD; Michael Stevens, Principal Project Manager, PUD/EPMD; Brett Rosenblum, Principal Project Manager, GMD/DRD; Utility Planning Section

GIS Screen Shot

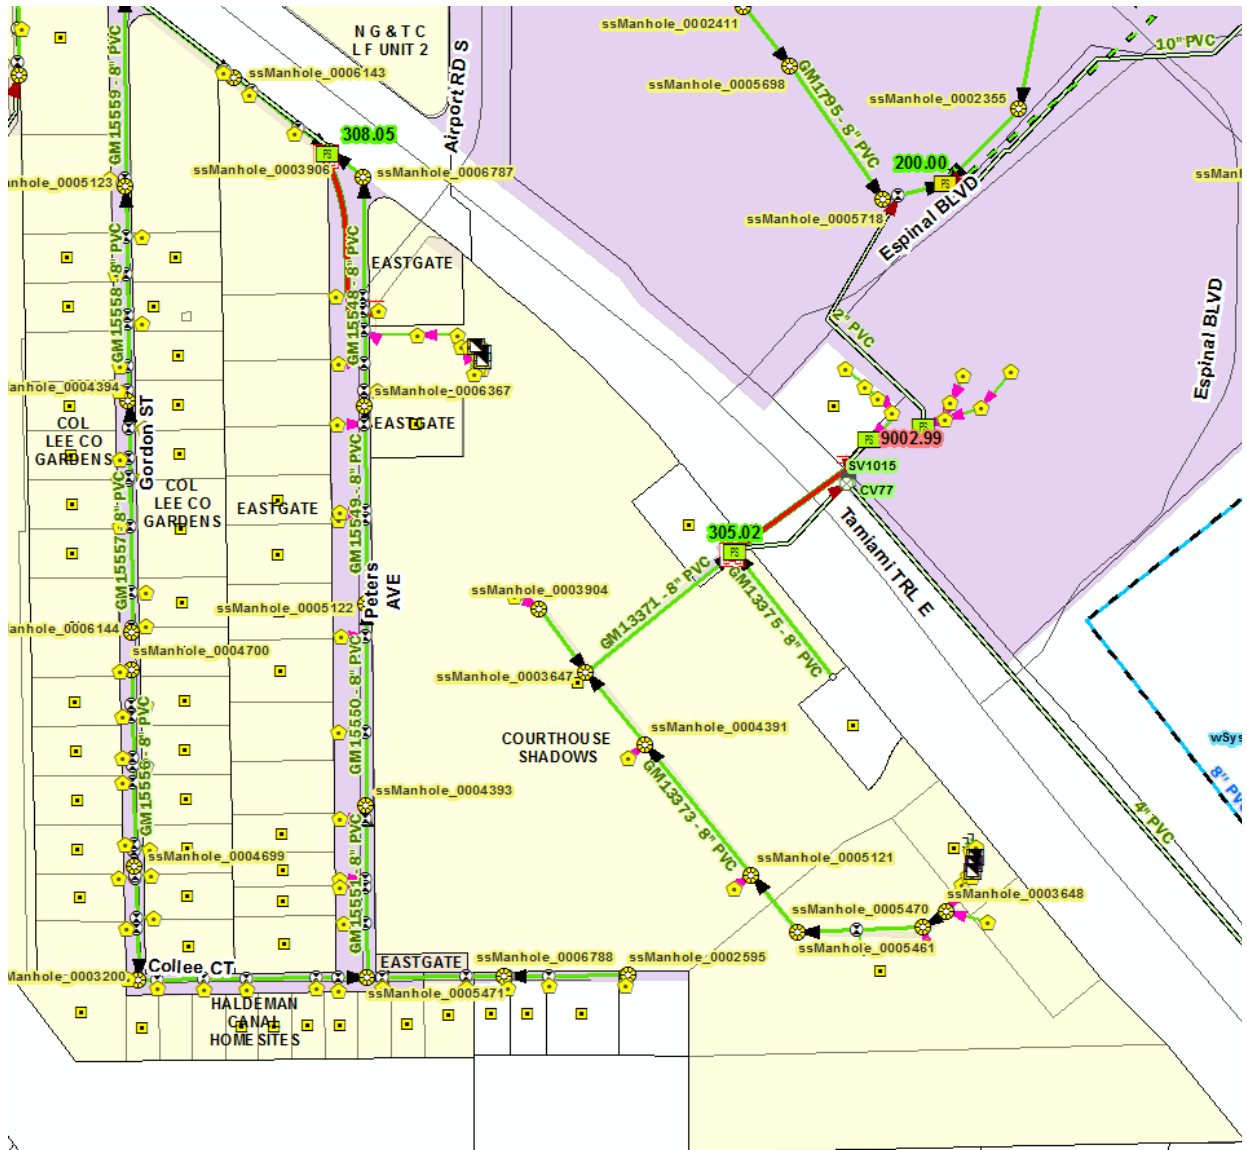

X